


ONE LAKESIDE COMMONS

SUITE 600

22,999 RSF

AS-BUILT PLAN

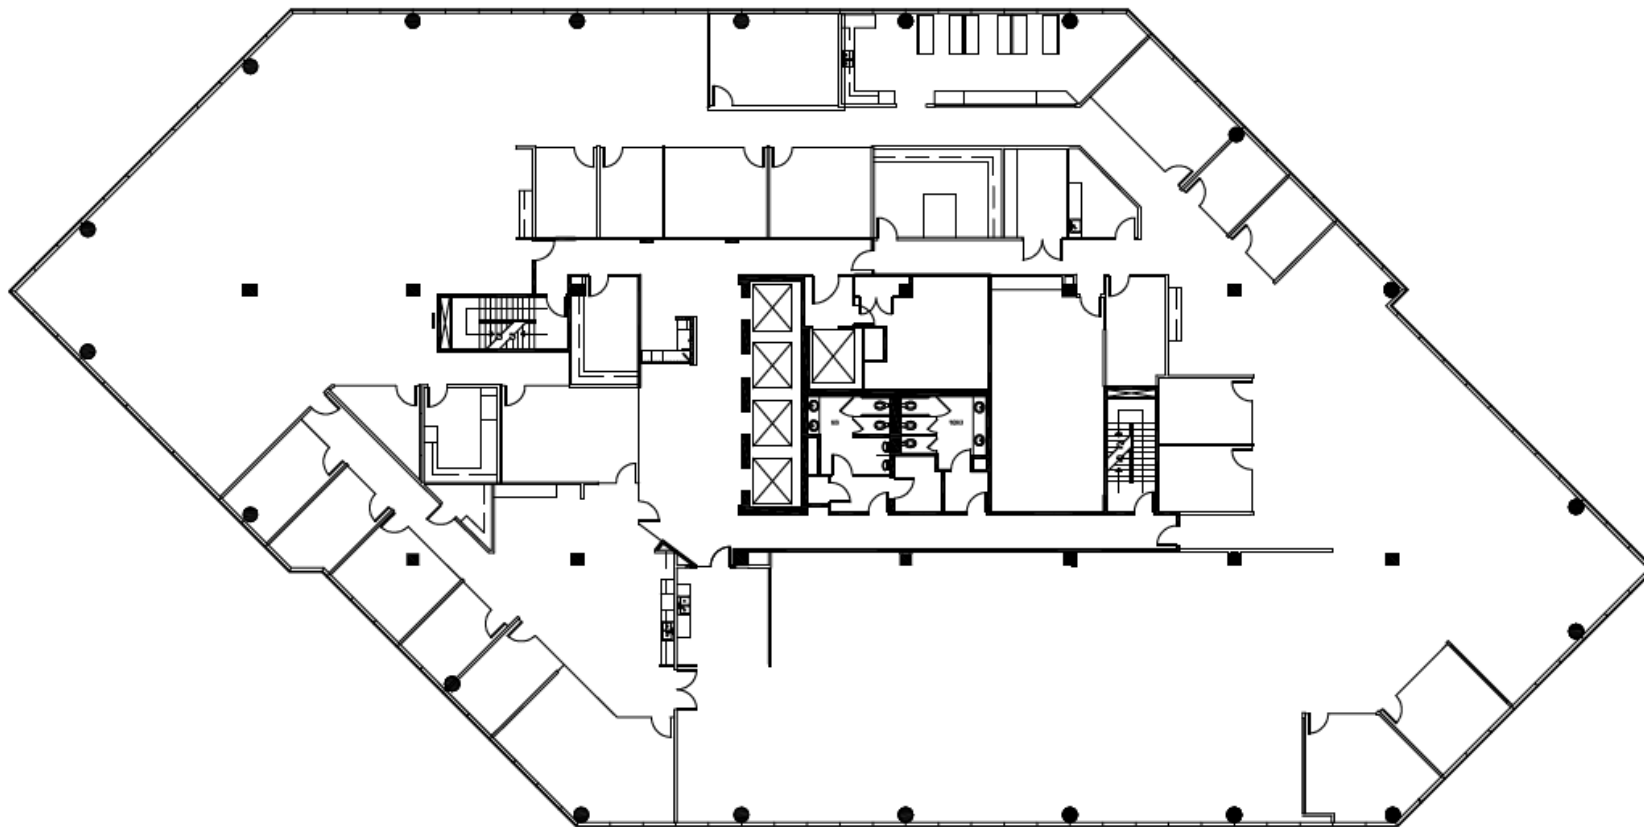

INTERCONTINENTAL  
REAL ESTATE CORPORATION

**NEWMARK**

One Lakeside Commons, 990 Hammond Drive, Atlanta, GA 30328

Tom Miller, Executive Managing Director | [tom.miller@nrmk.com](mailto:tom.miller@nrmk.com) | 770.552.2411